



CONSTRUCTION DETAILS

- A. Install NEMA size "6" base mounted cabinet and controller with all necessary equipment as shown, (Note: 2-2" and 2-4" (schedule 80) 90° PVC bends).
- B. Install handhole.
- C. Install 6' x 6' loop detector encased in flexible tubing (4 turns).
- D. Install 1" liquid tight non-metallic flexible conduit for detector sleeve.
- E. Install 1" galvanized steel electrical conduit for detector sleeve.
- F. Install 3" schedule 80 rigid PVC electrical conduit - trenched.
- G. Install 4" schedule 80 rigid PVC electrical conduit - trenched for service.
- H. Install 4" schedule 80 rigid PVC electrical conduit - trenched.
- J. Install 4" schedule 80 rigid PVC electrical conduit - bored.
- K. Install 6' x 30' loop detector encased in flexible tubing (quadrupole 3-6-3).
- L. Install microloop probe set with 500' lead-in.
- M. Install 24" white heat applied thermoplastic pavement marking (stop line).
- N. Install 27' steel pole with 60' mast arm and signal heads, sign as shown, (Note: 1-3" 90° PVC bend).
- O. Install 27' steel pole with 50' mast arm, signal heads and sign as shown, (Note: 1-3" 90° PVC bend).
- P. Install 27' steel pole with 70' mast arm, signal heads and sign as shown, (Note: 1-3" 90° PVC bend).
- Q. Use existing handhole and conduit to install probes.
- R. Use existing electrical handhole.
- S. Use existing conduit.
- T. Remove existing and controller cabinet and all attached equipment. (Foundation shall be removed 12" below grade).
- U. Remove existing steel pole and all attached equipment. (Foundation shall be removed 12" below grade).
- V. Remove existing sidewalk or monolithic median concrete and replace after the installation of the proposed signal equipment.
- W. Install microloop probe set with 1000' lead-in.
- X. Install 4" schedule 80 PVC electrical conduit for BG&E supplied service.


PROPOSED SIGNS

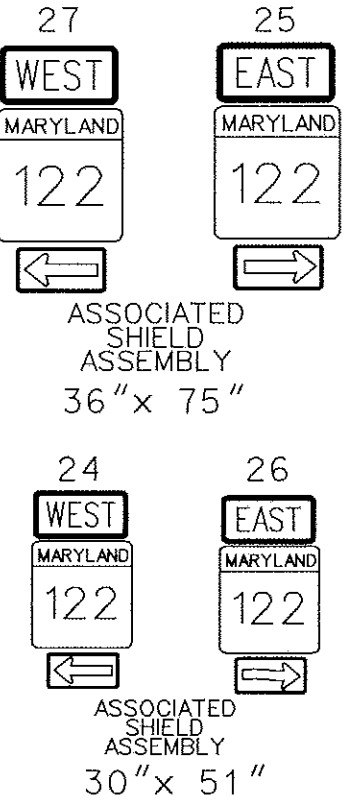

PROPOSED SIGNALS

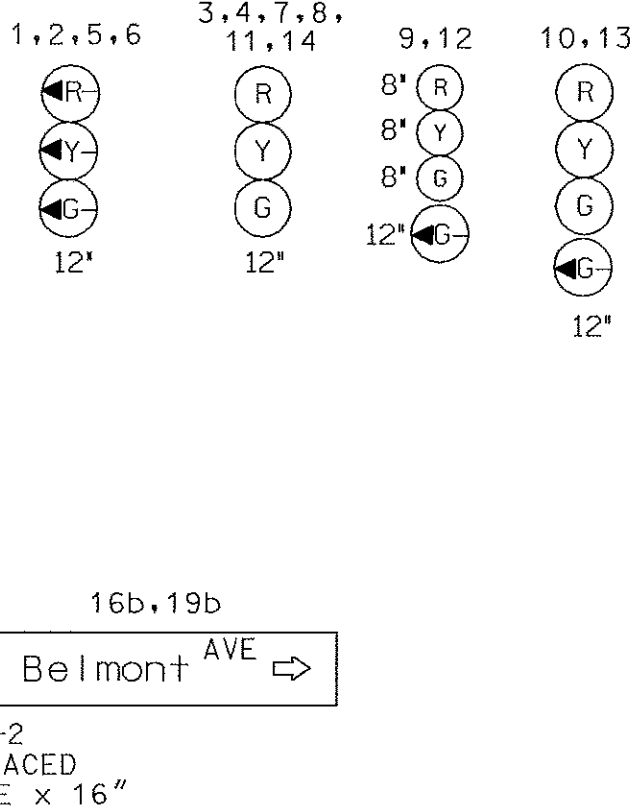

NEMA PHASING

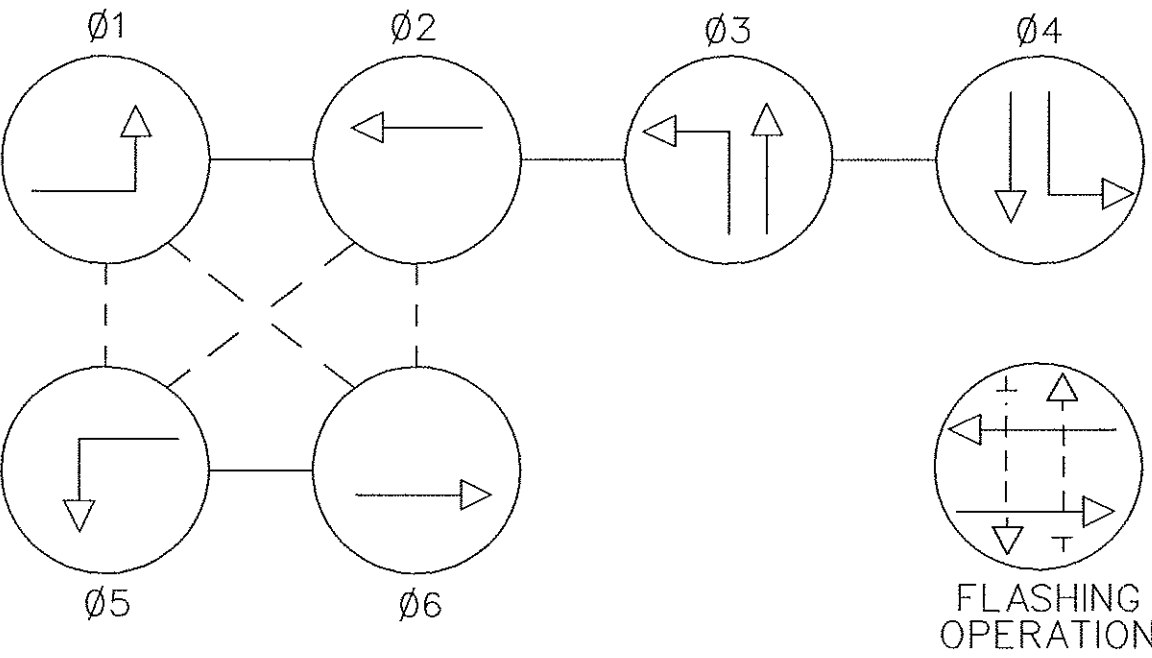

Phasing Notes:
1.) Phases associated by a dashed line will operate concurrently.
2.) Phases associated by a solid line will not operate concurrently.

GENERAL NOTES:

1. This plan reflects only those underground utilities that were apparent at the time of this location being asbuilt. A detailed review was not undertaken and this plan should not be construed as representing all underground utilities in the area.
2. Any modification to this subject signal should be preceded by a thorough identification of all existing utilities.
3. See General Information sheet for phasing and wiring details (See sheet 8 of 8).
4. All pavement markings detailed are proposed and are to be installed in accordance with SHA standards.
5. The loop detectors and conduit shall be installed prior to the installation of the pavement markings.
6. The R4-7 "KEEP RIGHT" signs and the street lighting are existing.

GEOMETRIC LEGEND	
PROPOSED	---
EXISTING	---
LEGEND OF UNDERGROUND AND OVERHEAD UTILITIES	
AERIAL CABLE	A
ELECTRIC	E
TELEPHONE	T
GAS	G
SEWER	S
WATER	W
CABLE TV	TV

REVISION "C"

STREET TRAFFIC STUDIES, LTD.

400 Crain Hwy., NW
Glen Burnie, MD 21061
Ph (410) 590-5500
Fax (410) 590-6637

PTASK29C.DGN.dgn

REVISIONS		APPROVALS	
1	REDLINE REVISION TO S.H.A. * XX1005885	9/4/00	ASST. CHIEF TRAFFIC ENGINEERING DESIGN DIVISION
2	RECONSTRUCT, ADD I/C AND SAMPLING S.H.A. * XX1005885	4/4/00	ASST. DISTRICT ENGINEER, TRAFFIC
3	OUT NEW LOOPS DUE TO THE WIDENING OF BELMONT AVE. S.H.A. NO: BW 757-802-412	August 4, 1994	CHIEF, TRAFFIC ENGINEERING DESIGN DIVISION
		DIRECTOR, TRAFFIC & SAFETY	



MARYLAND DOT - STATE HIGHWAY ADMINISTRATION
Office of Traffic & Safety
TRAFFIC ENGINEERING DESIGN DIVISION
MD 122 AND BELMONT AVE./
ENT. TO SECURITY MALL

DRAWN BY: S.T.S.	F.A.P. NO. 3457C	TS NO. 3457C	SHEET NO. 3 OF 8
CHECKED BY: 1" = 20'	S.H.A. NO. BALTIMORE	T.I.M.S. NO. D670	
DATE: 3/4/2000	LOG MILE: 03012200.27		